


BLANDFORD MODEL

16 X 67

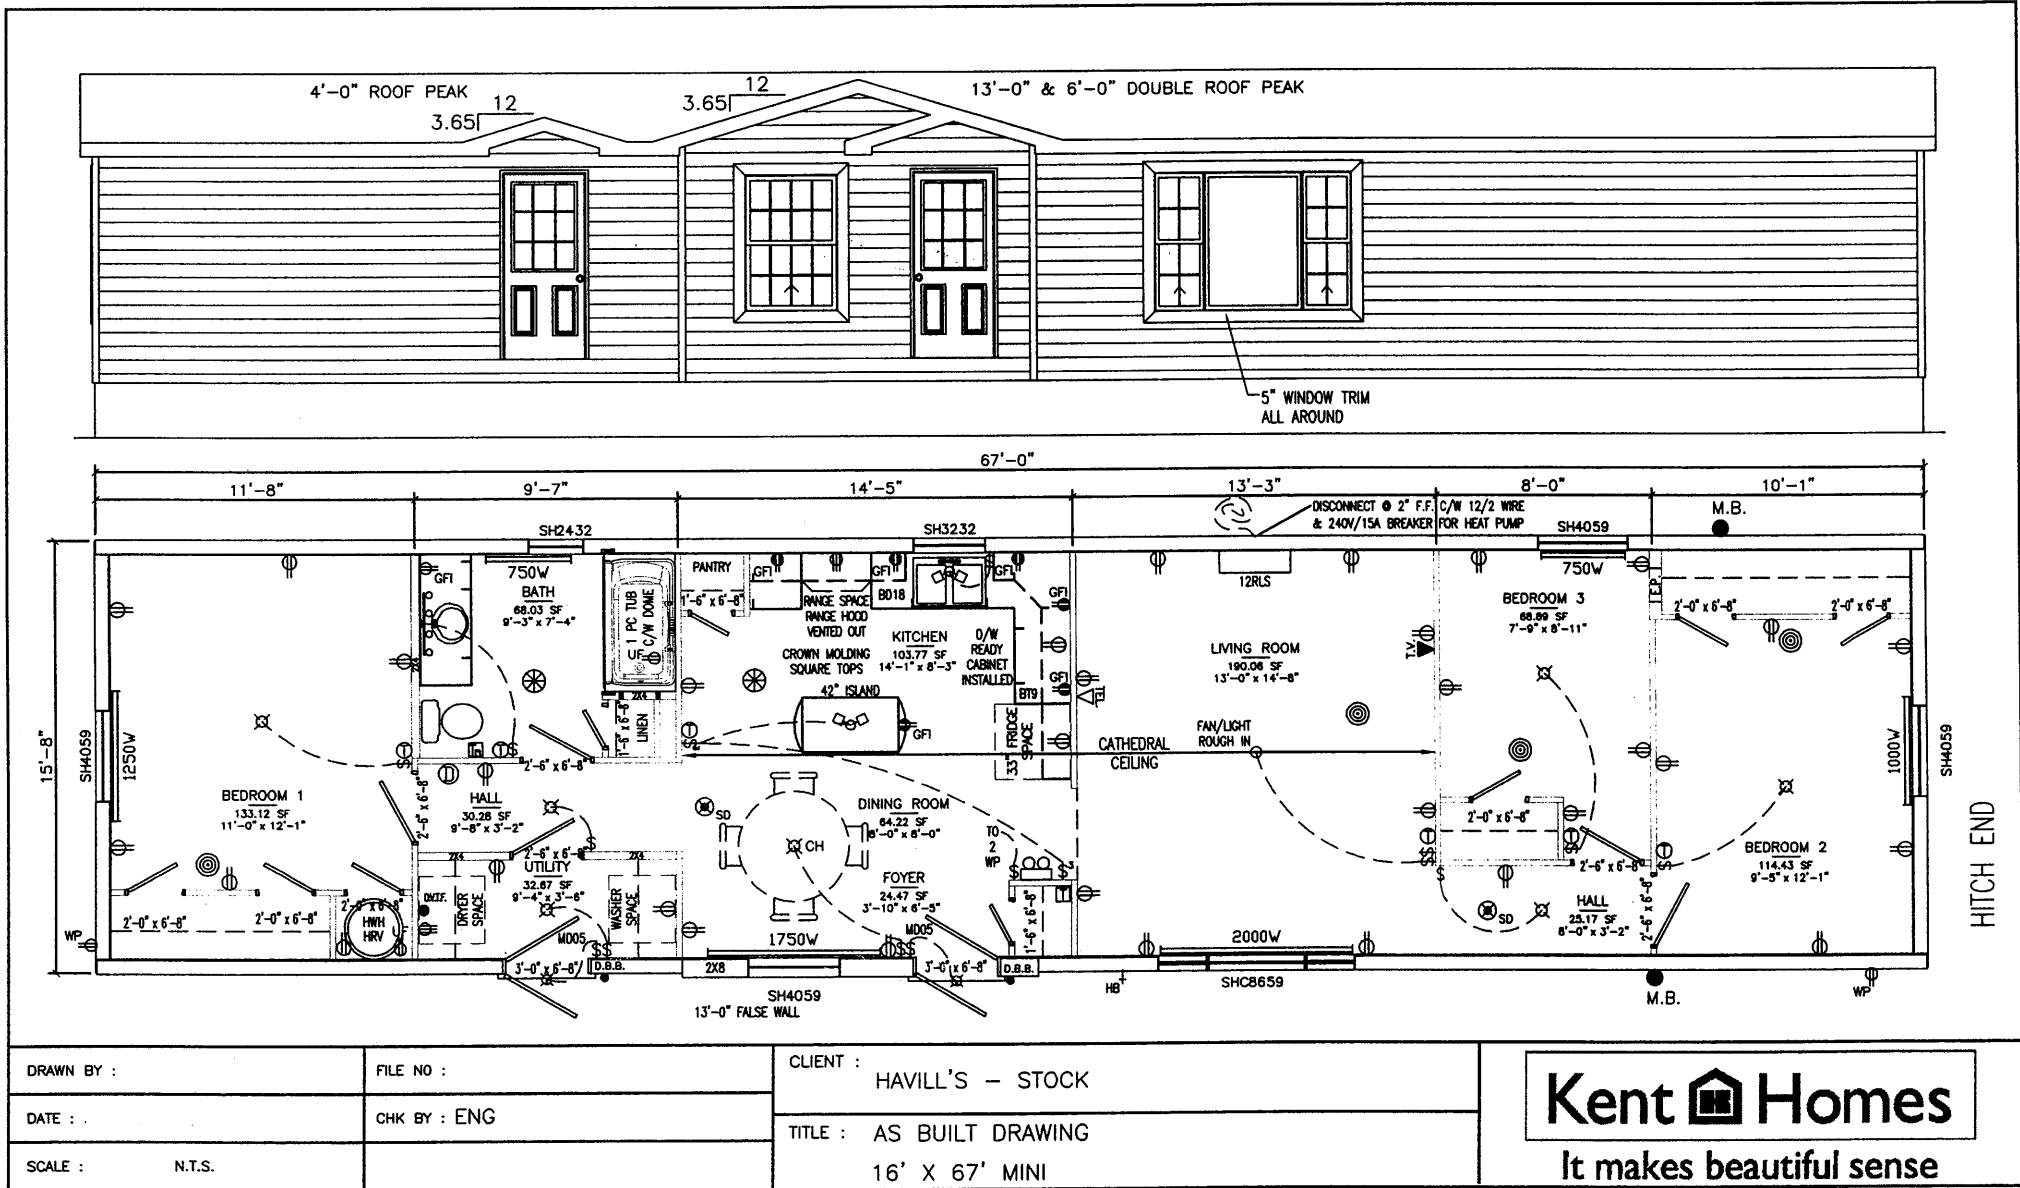

DRAWN BY :
DATE :
SCALE : N.T.S.

FILE NO :
CHK BY : ENG

CLIENT : HAVILL'S - STOCK
TITLE : AS BUILT DRAWING
16' X 67' MINI

Kent Homes
It makes beautiful sense

3 Bedrooms