


CHESTER MODEL

16 X 72

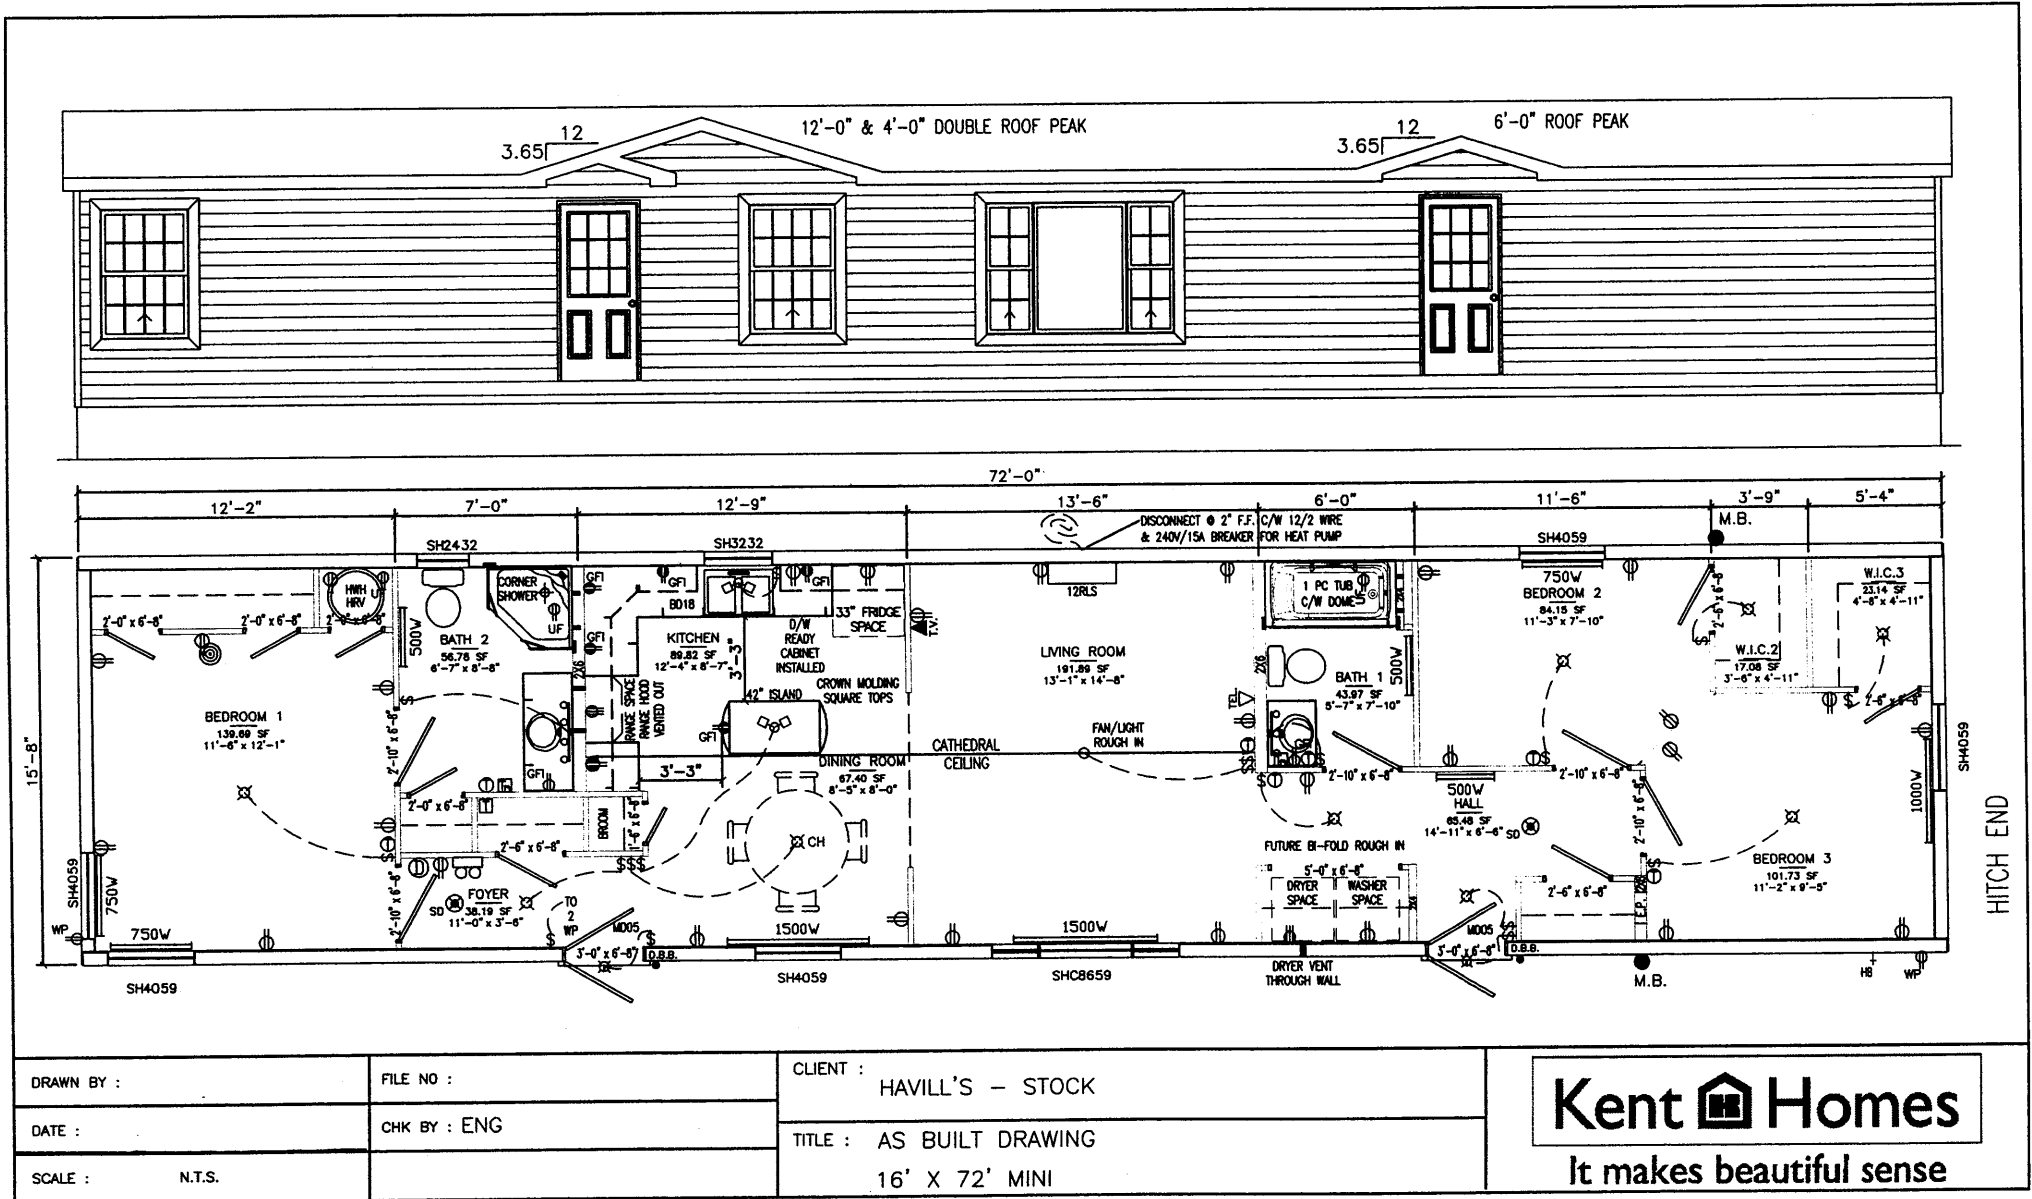

DRAWN BY :	FILE NO :
DATE :	CHK BY : ENG
SCALE : N.T.S.	

CLIENT :	HAVILL'S - STOCK
TITLE :	AS BUILT DRAWING 16' X 72' MINI

Kent Homes
 It makes beautiful sense

3 Bedrooms, 2 Bathrooms