CHESTER MODEL

16 X 72

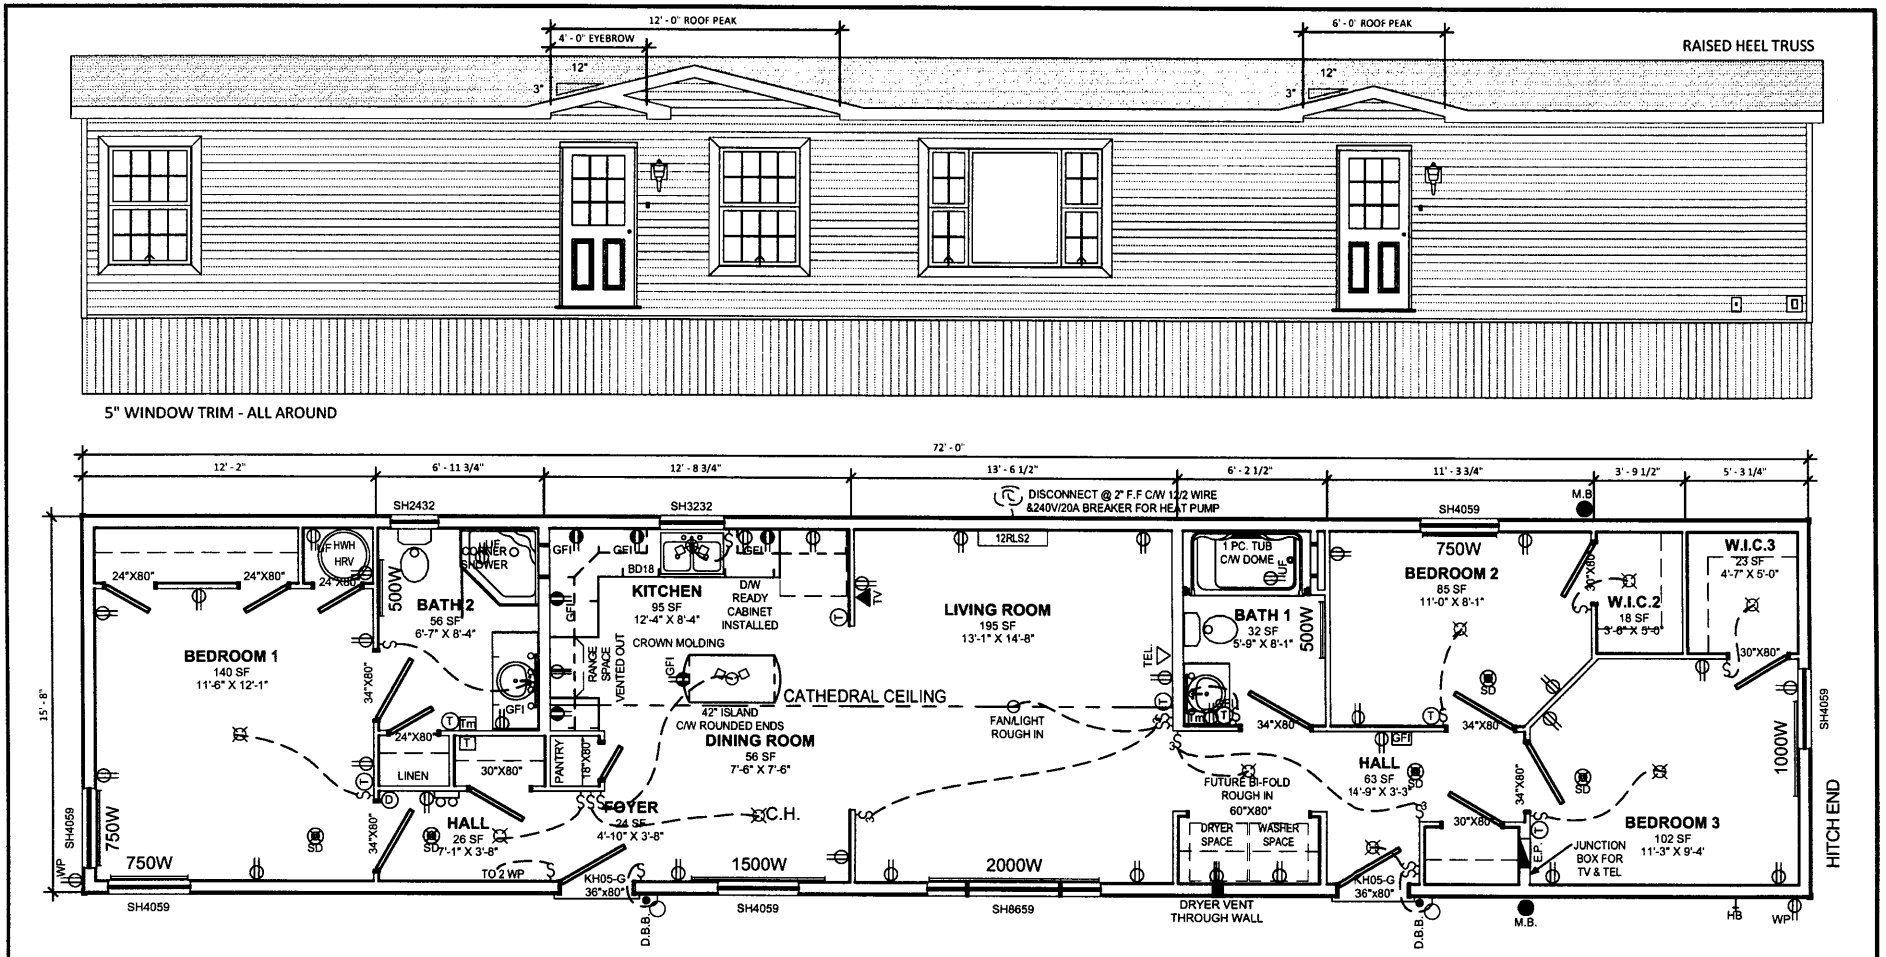

DRAWN BY:	FILE NO:	CLIENT: HAVILL'S - STOCK	Kent Homes
DATE:		TITLE: AS BUILT DRAWING - FLOOR PLAN & FRONT ELEVATION	It makes beautiful sense
SCALE:	CHK BY: ENG.	15'-8" X 72'-0" MINI	

3 Bedrooms, 2 Bathrooms